723
U. S. COAST GUARD
723

378-FRAM-W-401-015 | SH 1 | REV M

GENERAL NOTES

1. FOR LOCATIONS OF TOPSIDE MOUNTED EQUIPMENT RELATED TO ANTENNAS, SUCH AS TUNERS, COUPLERS, AMPLIFIERS, ETC., SEE ARRANGEMENT OF ELEC EQUIPMENT 02 DECK AND ABOVE (REFERENCE 21).

2. BONDING AND GROUNDING OF EQUIPMENT SHALL BE IN ACCORDANCE WITH MIL-STD-1310D, FOR BONDING AND GROUNDING OF ELECTRONIC EQUIPMENT, SEE REFERENCE 22.

3. ALL ABBREVIATIONS ARE IN ACCORDANCE WITH MIL-STD-12, UNLESS OTHERWISE NOTED.

4. THE FOLLOWING NON-STANDARD ABBREVIATIONS ARE USED ON THIS DRAWING:

   - I & BWD : (ISOMETRIC AND BLOCK WIRING DIAGRAM)
   - B & IWD : (BLOCK AND ISOMETRIC WIRING DIAGRAM)
   - IWD : (ISOMETRIC WIRING DIAGRAM)
   - N : (NEW)
   - E : (EXISTING)
   - R : (REUSED OR RELOCATED)
   - EIL : (EQUIPMENT IDENTIFICATION LIST)

5. (D3) SYM/MODEL AND OUTLINE & MTG DWG NO COLUMNS CONTAIN INFORMATION RELATING TO EXISTING NAVIGATION LIGHTS. IF NAVIGATION LIGHTS ARE REPLACED. REFER TO REF 20 FOR CURRENT HULL APPLICABILITIES AND TABLE BELOW.

FN	NOMENCLATURE	OLD SYM	NEW SYM	OUTLINE & MTG DWG NO.
54	UPPER MAN OVBD & BREAKDOWN LIGHT	115	115.1	MIL-L-24560/2
55	LOWER MAN OVBD & BREAKDOWN LIGHT	115	115.1	MIL-L-24560/2
56	FWD ANCHOR LIGHT (WHITE)	161.3	161.4	MIL-L-24560/23
57	AFT ANCHOR LIGHT (WHITE)	161.3	161.4	MIL-L-24560/23
58	MASTHEAD LIGHT (WHITE)	172.1	172.2	MIL-L-24560/10
59	RANGE LIGHT (WHITE)	172.1	172.2	MIL-L-24560/10
60	UPPER TOWING LIGHT (WHITE)	172.1	172.2	MIL-L-24560/10
61	LOWER TOWING LIGHT (WHITE)	172.1	172.2	MIL-L-24560/10
62	PORT SIDE LIGHT (RED)	182.1	182.2	MIL-L-24560/9
63	STBD SIDE LIGHT (GREEN)	183.1	183.2	MIL-L-24560/9
64	STEERING LIGHT (WHITE)	195.1	195.1	MS 17318
65	STERN LIGHT (CLEAR)	196.1	196.3	MIL-L-24560/8
66	BLINKER LIGHT (PORT)	191.2	191.2	MIL-L-24560/5
67	BLINKER LIGHT (STBD)	191.2	191.2	MIL-L-24560/5
68	12" SEARCH LIGHT	66.1	66.1	MIL-S-19551
70	UNDERWATER TASK LIGHT (MIDDLE)	114	192.1	MIL-L-24560/6
73	AIRCRAFT WARNING & SPEED LIGHT (PORT)	115	160.1	MIL-L-24560/1
74	AIRCRAFT WARNING & SPEED LIGHT (STBD)	115	160.1	MIL-L-24560/1
75	ASW LIGHT	176	176	HUBBELL 15365
76	STERN TOWING LIGHT	196.1	196.3	MIL-L-24560/8
77	STERN TOWING LIGHT (PORTABLE)	196.4	196.4	MIL-L-24560/8

6. (D) RELOCATE THE MODEL 8171 SPECTRUM ANTENNA TO THE YARDARM INSTALL THE AS-3819/SRN ANTENNA ON THE VACATED FOUNDATION.

REFERENCES

NO.	TITLE	DRAWING NO.	
1	TACAN SYS AN/URN-25 CKT "IR-RN" I & BWD	378-FRAM-W- 423-003	
2	~~RAD ANT SYS CKT "R-RA" BLK & IWD~~	~~441-003~~	G3
3	~~SATL RCVG SYS AN/SRR-1 BLK & IWD~~	~~441-007~~	G3
	~~CKT R-ES BLK & IWD~~		
4	~~SURFACE SEARCH RADAR SYS AN/SPS-64(V)4~~	~~451-001~~	H5
	~~I & BWD~~		
5	AIR SRCH RDR SYS AN/SPS-40( ) CKT "R-EA"	452-001	D2
6	RDR IFF SYS CKT "R-1C" & "R-1T" BLK & IWD	455-001	
	& AN/SKR-4 I & BWD		
7	SONAR SIGNAL PROCESSING SYS AN/SQR-17A (V)1	460-001	
8	SATL XCVR SYS AN/WSC-3(V)3 I & BWD	441-008	
	"R-CI" AND "R-IE" ISOMETRIC AND BLK WRG DIAG		
9	ELECTRONIC COUNTERMEASURE SYSTEM CIRCUIT	472-003	D1
10	GUN FIRE CONT SYS MK92 MOD1 BLK & IWD	481-004	
11	ELEX NAVIGATIONAL SYS I & BLK WRG DIAG	423-001	
	CKT TV BLK & IWD		
12	RECREATION TV & ENTERTAINMENT SYSTEM	434-001	
13	ANTENNA FOUNDATIONS	184-001	
14	JACK & ENSIGN STAFF	611-002	
15	FOREMAST	171-003	
16	MAINMAST	171-001	
17	~~ANTENNA EQPT FOUNDATIONS~~	~~184-007~~	D1
18	ELEX & ELEC FOUNDATIONS MN DK & ABOVE	184-003	
19	ANTENNA DETAILS	405-002	
20	RUNNING, SIGNAL & ANCHOR LIGHTS - IWD	422-001	
21	ARR OF ELEC EQPT 02 LEVEL & ABV	301-008	D1
	SCHEDULE AND DETAILS		
22	BONDING & GROUNDING OF ELECTRONIC EQPT	406-002	
23	AN/WRN-6(V) ARRANGEMENT, INSTALLATION & BWD	378-FRAM-W- 423-100	E
24	MAST & PLATFORM FOR INMARSAT MX 2400 ANTENNA	378-FRAM-W- 441-101	F
25	RADIO COMMUNICATIONS BLOCK WIRING DIAGRAM & DETAILS	378-FRAM-W- 441-015	G3
26 (H3)	INMARSAT STANDARD-C SYS B.W.D. & DETAILS	378-FRAM-E- 441-029	
27	AN/SPS-73(V)4 SRFC SRCH RDR BLK WRG DIAG & DETAILS	378-FRAM-E- 451-030	H7
28 (J1)	INMARSAT-C UPGRADE ARR & DETAILS	FL-6700-74	
29 (K2)	DEEPWATER AIS - CABLE BLOCK DIAGRAM	378-FRAM-E-423-013	
30	DEEPWATER AIS - CABLE RUN SHEET	378-FRAM-E-423-014	
31	DEEPWATER LAW MARINE AND DSC RADIO - CBD	378-FRAM-E-441-033	
32 (K2)	DEEPWATER LAW MARINE AND DSC RADIO - CRS	378-FRAM-E-441-034	
33 (L2)	SEI EQUIPMENT AN/SSX-1 BWD AND DETAILS	378-FRAM-E-441-034	
34 (M5)	SIRVSS & CVRS BWD & INSTALL DETAILS	FL-6701-221	
35 (M6)	SINS NAVIGATION SYSTEM BWD & DETAILS	378-FRAM-E-423-017	

REVISIONS

ZONE	REV	DESCRIPTION	DATE	APPROVED
ALL	A	ORIGINAL ISSUE	JK	6-3-86
ALL	B	1. REVISED DRAWING IN ITS ENTIRETY. THIS REVISION INCLUDES THE FOLLOWING CHANGES:		
ALL		2. EXTENDED DRAWING APPLICABILITY TO HULL 720. THE ABOVE CHANGE INCORPORATES ECN FE-083.		
VAR		3. CHANGED NOMENCLATURE OF ANTENNAS 1-10A THROUGH 1-10D (F/N 10 THROUGH 13) FROM AS-2815/SSR-1 TO AS-2815/SSR-1A AND TITLE OF REFERENCE 3 FROM SAT RECEIVING SYSTEM AN/SSR-1 B & IWD TO SAT RECEIVING SYSTEM AN/SSR-1A B & IWD. THE ABOVE CHANGES INCORPORATE MOD-0068.		
VAR		4. CHANGED ANTENNA 4-3 (F/N 31) FROM AS-514B/URD-4 TO CDYM-TD-L1650, ADDED ANTENNA IFF AS-177B/UPX (SP & WT) (F/N 53). RELOCATED ANTENNAS 1-10A, 1-10B, 2-5, 3-3 AND CCEM-390-2 (F/N 10, 11, 18, 27 AND 46 RESPECTIVELY). THE ABOVE CHANGES INCORPORATE MOD-0035.		
ALL		5. LIFTED RESERVATIONS 1 AND 2 AND EXTENDED DRAWING APPLICABILITY TO HULL 724.	DCL	4/13/88
SH 2 EIL; SH 3 3F 4F; SH 4 5D 4F	C	1. ADDED ASW LIGHT F/N 75. REVISED PLAN 4-A (SH 3) & ELEV 4-A (SH 4) TO SUIT. REVISED QTY OF 12" SEARCH LIGHT F/N 68 FROM 4 TO 2 & ADDED ALTERNATE LOCATION NOTATION TO ONE (1) EACH, PORT & STBD 12" SEARCH LIGHT ON BODY OF DWG. THE ABOVE CHANGES INCORPORATE ECN FE-1183.		
SH 2 EIL		2. REVISED SYM/MODEL COLUMN FOR ANTENNA 1-9 (FREQ & TIME STD) F/N 9 FROM 8206 TO CEES-8206 AND ANTENNA (TACAN) F/N 45 FROM AS-3240/URN TO AS-3240 ( )/URN. THE ABOVE CHANGES INCORPORATE MOD 0087.		
SH 2 EIL		3. REVISED SOURCE UNDER QTY COLUMN FOR ANTENNA 1-2, 1-3, 1-9, 2-2, 2-5, 2-13 AND 2-15, F/N 1, 2, 9, 15, 18, 23, AND 24 RESPECTIVELY. THE ABOVE CHANGES INCORPORATE MOD 0109.		
SH 2 EIL		4. REVISED NOMEN COLUMN FOR ANT 1-2, 1-3, 1-6, 1-7 AND WHIP (HF, SHORT RANGE) ANTENNA AND UNDERWATER TASK LIGHT F/N 1, 2, 6, 7, 46 AND 70 RESPECTIVELY.		
SH 2 EIL		5. REVISED ORD REF COLUMN FROM REF 2 TO REF 19 FOR ANTENNA 1-5A, 1-5B, 3-3, 3-4, 3-5 AND 3-6, FN 4, 5 AND 27 THRU 30 RESPECTIVELY.		
SH 2 EIL		6. REVISED SYM/MODEL COLUMN FOR 12" SEARCHLIGHT, INFRARED XMTR BEACON (PORT) AND INFRARED XMTR BEACON (STBD) F/N 68, 71 & 72 RESPECTIVELY.		
SH 2 EIL		7. REVISED REMARKS COLUMN FOR F/N 54 THRU 67, 69, 70, 73 AND 74.		
SH 2 EIL		8. REVISED OUTLINE AND MTG DWG NO. COLUMN FOR 19" SEARCH LIGHT F/N 69.		
SH 2 EIL; SH 3 5F,8F; SH 4 5E,8C		9. ADDED STERN TOWING LIGHT, STERN TOWING LIGHT ((PORTABLE) AND WHISTLE LIGHT F/N 76, 77 & 78 RESPECTIVELY. REVISED BODY OF DWG TO SUIT.		
SH 4 4D		10. REVISED DEPICTION OF ANT 2-5 AND 2-14 F/N 18 AND 46 RESPECTIVELY TO REFLECT A HEIGHT OF 23 FT.		
ALL		11. EXTENDED DWG'S APPLICABILITY TO HULLS 719, 722, 723, 725 AND 726. REVISION ITEMS 4 THRU 11 DUE TO DESIGN DEVELOPMENT.	12/6/88	DCL
SH1 REF	D	1. REVISED REF 9, 21. DELETED REF 17.		
		2. REVISED REF 5 TO INC ECN FE-1633.		
GN		3. ADDED GN 5.		

REVISIONS CONT'D IN ZONE 2-H

REVISIONS (CONTINUED)

ZONE	REV	DESCRIPTION	DATE	APPROVED
SH2 B/M	D (CONT'D)	4. REVISED NOMENCLATURE OF FN39 FROM "AS-2782/SPS-40B" TO "AS-2782/SPS-40( ) TO INC ECN FE-1633. 5. REV FN54 THROUGH FN68, FN70, FN73 THROUGH FN77. ITEMS 1-3 & 5 INC DWG CHANGES.		
SH 1 6H	E	ADDED REFERENCE 23	11-15-94	BY: RWW SKA; APPVD: RGM/S/ KSL/S/ RVS/S/
SH 2 3E		CHANGED FIND NO'S 25 & 26 FM MLA-2D/CG TO MLA-324 & MLA-1E-CG TO MLA-115 RESPECTIVELY		
SHTS 2, 3, 4		ADDED FIND NO'S 79, 80 & 81; GEN NOTE 6. DELETED FIND NO'S 32 & 47		
SH 4 4F		ADDED DETAIL 2-F/4		
ALL		CONVERTED TO AUTO-CAD FORMAT IAW COMDT INST M9085.1. THE FOLLOWING VIEWS WERE RENUMBERED AS FOLLOWS: WAS: SHT 3: PLAN 4-A → IS: PLAN VIEW; WAS: SHT 4: ELEV 4-A → IS: 5-B/4. THIS REVISION REFLECTS THE SCCS INSTALLATION IAW PROJECT 23412 & MINILOOP REPLACEMENT PROJECT 32809.		
ALL	F	THIS REVISION REFLECTS THE INMARSAT STD "A" SYSTEM INTALLATION IAW PROJECT 32906. ADDED FIND #82, ADDED REF #24.	6-22-95	BY: REC; RGM/S/ KSL/S/ RVS/S/
	G	THIS REVISION REFLECTS UPDATES AND CHANGES IAW PROJECT 24802.	8-1-96	BY: RWW; RGM/S/ KSL/S/
3&4		1. RELOCATED PC #31.		
2&4		2. ADDED PC #83.		
1		3. DELETED REF'S #2, 3 & 7. ADDED REF #25.		
	H	ITEMS 1 THRU 4 REFLECT UPDATES AND CHANGES IAW PROJECT 35901.	5-8-00	BY: DAK; RGM/S/ RBS/s/ KSL/S/
SH 2 4-F; SH 3,4 ALL		1. ADDED PC #84.		
SH 4 8-F		2. ADDED DET 8-F/4.		
SH 1 6-F		3. ADDED REF #26.		
SH 1 4-D 3-A		4. REVISED PLAN DISTRIBUTION TABLE & INDEX.		
		ITEMS 5 THRU 7 REFLECT UPDATES AND CHANGES IAW PROJECT 24406.		
SH 2 4-D; SH 1 4-H		5. DELETED PC# 38 & 40, REF #4		
SH 2 8-E,F; SH 3,4 ALL		6. ADDED PC# 85 THRU 88.		
SH 1 6-F		7. ADDED REF# 27		
	J	THIS REVISION REFERENCES, UPDATES, AND CHANGES IAW PROJECT 50402	08-04-04	BY: WES; RGM SPM
1		1. ADDED REF #28		
1		2. REVISED INDEX		
2,3,4		3. REVISED FN 84		
		4. REVISED DETAIL 8-F/4		
	K	THIS REVISION INCORPORATES THE INSTALLATION OF AIS AND LAW MARINE AND DSC RADIOS.	07-31-06	BY: GBS; JFH/S/
1		1.UPREV'D INDEX AND PLAN APPLICABILITY		
1		2.ADDED REFERENCES #29 TO #32		
2,3,4		3.ADDED PC#89 TO PC#94		
	L	THIS REVISION IAW PROJECT 23802 AN/SSX-1 SEI EQUIPMENT INSTALLATION	09-08-08	BY: AFS; CHK'D: RGM; SPM/S/
1		1. REVISED TITLE SHEET		
2,3,4		2. ADDED ANTENNA 5-8, ITEM #95, REF. #33		
		3. DELETED ITEM #49		

REVISIONS CONT'D IN ZONE 4-C

REVISIONS (CONTINUED)

ZONE	REV	DESCRIPTION	DATE	APPROVED
	M	THIS REVISION IAW PROJECTS 28815 SINS NAVIGATION SYSTEM INSTALLATION & 23802 SIRVSS INSTALLATION. ANTENNA POSITIONS DERIVED FROM SITE SURVEY ON CGC SHERMAN (HULL 720)	01/23/09; 02/13/09; 5/27/09	BY: AFS/WES; CHK'D: WES/AFS; SPM/S/ CGYard
SH. #1 ALL		1. REVISED TITLE SHEET		
8-E/2 4-C/3 3-F/4		2. ADDED ANTENNA 6-4.		
8-E/2 3-F/3 3-F/4		3. ADDED ANTENNA 1-15.		
4-C/3 4-E/4 4-C/2		4. DELETED ANTENNA 8-2 (ITEM #43)		
6-E/1		5. ADDED REFERENCE #34.		
8-F/2		6. REVISED FIND NO. 82.		
8-D/2 4-D/3 4-F/4		7. ADDED FIND NO. 98.		
6-E/1		8. ADDED REFERENCE #35.		

INDEX

SH	DESCRIPTION	REVISION							
1	DWG TITLE, REFERENCES, REVISIONS AND GENERAL NOTES, PLAN APPLICABILITY & PLAN DIST.	E	F	G	H	J	K	L	M
2	EQUIPMENT IDENTIFICATION LIST	E	F	G	H	J	K	L	M
3	ARRANGEMENT, PLAN	E	F	G	H	J	K	L	M
4	ARRANGEMENT, ELEVATION 5-A/4 & DETAIL 2-F/4	E	F	G	H	J	K	L	M

PLAN APPLICABILITY

HULL NO.	CUTTER NAME	ALT	DATE S/A COMPLETED	DATE S/A CERTIFIED
726	MIDGETT	M		
725	JARVIS	M		
724	MUNRO	M		
723	RUSH	M		
722	MORGENTHAU	M		
720	SHERMAN	M		
719	BOUTWELL	M		
717	MELLON	M		

DISTRIBUTION STATEMENT D- DISTRIBUTION AUTHORIZED TO DHS/CG/DOD AND THEIR CONTRACTORS; ADMINISTRATIVE AND OPERATIONAL PURPOSE; <DATE>. OTHER REQUESTS SHALL BE REFERRED TO: COMMANDING OFFICER, USCG ELC 05T, 2401 HAWKINS POINT ROAD, MAIL STOP 25/STINFO PROJECT MANAGER, BALTIMORE, MD 21226-5000

WARNING-THIS DOCUMENT CONTAINS TECHNICAL DATA WHOSE EXPORT IS RESTRICTED BY THE ARMS EXPORT-CONTROL ACT (TITLE 22, U.S.C. SEC 2751, ET. SEQ.) OR THE EXPORT ADMINISTRATION ACT OF 1979, AS AMENDED, TITLE 50, U.S.C. APP 2401 ET. SEQ. VIOLATIONS OF THESE EXPORT LAWS ARE SUBJECT TO SEVERE CRIMINAL PENALTIES.

DESTRUCTION NOTICE-FOR UNCLASSIFIED, LIMITED DOCUMENTS, DESTROY BY ANY METHOD THAT WILL PREVENT DISCLOSURE OF CONTENTS OR RECONSTRUCTION OF THE DOCUMENT.

PLAN DISTRIBUTION (* = SEPIA, O = ORIGINAL, E = SERVER) — DATE ISSUED: 11-18-94, 6-30-95, 8-12-96, 5-15-00

USCG YARD, 2401 HAWKINS POINT RD BALTIMORE, MARYLAND 21226-1797	U.S. COAST GUARD HEADQUARTERS WASHINGTON, D.C. 20593
DESIGN: L. CLEMMENS 12/5/88	NAVAL ENGINEERING DIVISION
DRAWN: L. CLEMMENS 12/5/88	378 FT WHEC
CHECKED: G. ARTEAGA	GENERAL ARRANGEMENT OF ANTENNA, RUNNING, ANCHOR AND SIGNAL LIGHTS
TODD APPVL; USCG APPVL; U.S.C.G. APPROVAL	SIZE H; FSCM CAGE NO 81340; U.S.C.G. DRAWING NO. 378-FRAM-W-401-015; REV M
INDUSTRIAL DEPARTMENT, CGYD	SCALE NONE; 10.42 SQ FT; SHEET 1 OF 4

SCALE FACTOR 1 ELECTRONIC FILENAME 378-FRAM-W_401_15_1_-_M.dwg

DWG NO 378-FRAM-W-401-015 REV M SH 2

EQUIPMENT IDENTIFICATION LIST (CONTINUED)

FIND NO.	NOMENCLATURE	SYM/MODEL	QTY N	QTY E	QTY R	OUTLINE & MTG DWG NO.	GFE	WT LBS	ORD REF	FDN REF	REMARKS
65	STERN LIGHT (CLEAR)			1				18	20	18	SEE GENERAL NOTE 5
66	BLINKER LIGHT (PORT)			1				25.6	20	15	SEE GENERAL NOTE 5
67	BLINKER LIGHT (STBD)			1				25.6	20	15	SEE GENERAL NOTE 5
68	12" SEARCH LIGHT			2					20	18	SEE GENERAL NOTE 5
69	19" SEARCH LIGHT			1		CARLISLE FINCH 19SL-6509			20	15	CROUSE-HINDS
70	UNDERWATER TASK LIGHT (MIDDLE)			1				2.5	20	15	SEE GENERAL NOTE 5
71	INFRARED XMTR BEACON (PORT)	67-12-31.2		1		T-438/SAT-2			20	15	
72	INFRARED XMTR BEACON (STBD)	67-12-31.2		1		T-438/SAT-2			20	15	
73	AIRCRAFT WARNING & SPEED LIGHT (PORT)			1				2.5	20	15	SEE GENERAL NOTE 5
74	AIRCRAFT WARNING & SPEED LIGHT (STBD)			1				2.5	20	15	SEE GENERAL NOTE 5
75	ASW LIGHT			1					20	15	SEE GENERAL NOTE 5
76	STERN TOWING LIGHT			1					20	18	SEE GENERAL NOTE 5
77	STERN TOWING LIGHT (PORTABLE)			1					20	18	SEE GENERAL NOTE 5
78	WHISTLE LIGHT		1			KAHLENBERG M350			20	15	
79	ANTENNA (GPS), P/N 819766-803	VOLUTE, MX-200	1				GFE				
80	ANTENNA COUPLER, P/N 798007-001-001	MSR-4050	2				GFE				MACKAY COMMUNICATIONS CORP.
81	ANTENNA, AN/WRN-6(V) GPS	AS-3819/SRN	1				GFE				
82	ANTENNA, NERA SATURN Bm		1				GFE			24	INMARSAT STD "B"
83	ANTENNA, VHF ADF, CFHN-IES-KDF-538		1				GFE				
84	ANTENNA, ADE, MDT-6000	TT-3005M	1				GFE				INMARSAT STD "C"
85	ANTENNA, SURFACE SEARCH X-BAND	AS-4474/SPS-73(V)4	1			HUGHES #XN5A (U)	GFE	300			W/PEDESTAL TYPE AB-1399/SPS-73(V)4
86	ANTENNA, SURFACE SEARCH S-BAND	AS-4475/SPS-73(V)4	1			HUGHES #SN5AF (U)	GFE	275			W/PEDESTAL TYPE AB-1400/SPS-73(V)4
87	TEST SET, RADAR, PERFORMANCE MONITOR, X-BAND	TS-4500/SPS-73(V)4	1			HUGHES #PM-30	GFE	20			
88	TEST SET, RADAR, PERFORMANCE MONITOR, S-BAND	TS-4499/SPS-73(V)4	1			HUGHES #PM-50	GFE	20			
89	ANTENNA 3-7 (VHF P-25 #1)	4265A	1								T04KKH9PW9N
90	ANTENNA 3-8 (VHF P-25 #2)	4265A	1								T04KKH9PW9N
91	ANTENNA 3-9 (UHF P-25)	4266	1								T04QKH9PW9N
92	ANTENNA 3-10 (VHF DSC)	5241-R	1								DSC500M000
93	ANTENNA 4-5 (VHF AIS)	954-VW	1								SAAB-R4
94	ANTENNA 4-6 (GPS AIS)	GPA-017	1								SAAB-R4
95	ANTENNA 5-6 (AN/SSX-1 ESM)	AS-1200B	1								AN/SSX-1 ESM EQUIPMENT
96	ANTENNA 6-4 (SINS NAVIGATION SYSTEM RADAR)	RSB-0071	1								SINS NAV EQUIP (24" DOME)
97	ANTENNA 1-15 (SINS NAVIGATION SYSTEM GPS RECEIVER, GP-37)	GPA-019	1								SINS NAV EQUIP. (GP-37 RECEIVER)
98	SIRVSS STABILIZED GIMBAL ASSEMBLY		1				GFE		34		FLIR SIRVSS SYSTEM

EQUIPMENT IDENTIFICATION LIST

FIND NO.	NOMENCLATURE	SYM/MODEL	QTY N	QTY E	QTY R	OUTLINE & MTG DWG NO.	GFE	WT LBS	ORD REF	FDN REF	REMARKS
1	ANTENNA 1-2, WHIP (HF RCVG)	CCEM-229	1			CG7610-01-GF1-0801		142	2	17	
2	ANTENNA 1-3, WHIP (HF RCVG)	CCEM-229	1			CG7610-01-GF1-0801		142	2	17	
3	ANTENNA 1-4, (MF/HF DF)	TD-C338HS	1			TD-C338HS		14	11	13	
4	ANTENNA 1-5A, LONG WIRE (HF)		1			SHOP FAB			19	13	
5	ANTENNA 1-5B, LONG WIRE (HF)		1			SHOP FAB			19	13	
6	ANTENNA 1-6, WHIP (MF RCVG)	AT-924A/SR	1			RE-F2695039		6	2	17	W/RF TUNER,TN-334A/SRA-17
7	ANTENNA 1-7, WHIP (MF RCVG)	AT-924A/SR	1			RE-F2695039		6	2	17	W/RF TUNER,TN-334A/SRA-17
8	ANTENNA 1-8 (RAYSAT 200)	CRP-NAU-3800R	1			CRP-NAU-3800R		2	11	13	
9	ANTENNA 1-9 (FREQ & TIME STD)	MODEL 8171	1			MODEL 8171		3	2	15	
10	ANTENNA 1-10A (SATL RCVG)	AS-2815/SSR-1A			1	0967-541-9010		12.75	3	13	
11	ANTENNA 1-10B (SATL RCVG)	AS-2815/SSR-1A			1	0967-541-9010		12.75	3	13	
12	ANTENNA 1-10C (SATL RCVG)	AS-2815/SSR-1A		1		0967-541-9010		12.75	3	17	
13	ANTENNA 1-10D (SATL RCVG)	AS-2815/SSR-1A		1		0967-541-9010		12.75	3	17	
14	ANTENNA 1-11 (LORAN "C")	M75/M68453	1			DC50-JNA-750M		2	11	13	W/COUPLER, AW-750
15	ANTENNA 2-2 (AM-VHF)	D-2216	1			TECH APPL D-2216		2	2	15	
16	ANTENNA 2-3 (UHF DIPOLE)	AT-150/SRC	1			RE-F2691919		5	2	15	
17	ANTENNA 2-4 (VHF)	NT-66095		1		0967-089-5010		5	2	15	
18	ANTENNA 2-5, WHIP (HF, SHORT RANGE)	CCEM-390-2	1			CCEM-390-2		27	2	13	
19	ANTENNA 2-8 (VHF)	NT-66095		1		0967-089-5010		5	2	15	
20	ANTENNA 2-9 (UHF DIPOLE)	AT-150/SRC	1			RE-F2691919		5	2	15	
21	ANTENNA 2-10 (UHF DIPOLE)	AT-150/SRC	1			RE-F2691919		5	2	15	
22	ANTENNA 2-11 (UHF DIPOLE)	AS-390/SRC	1			RE-F2691919		9	2	15	
23	ANTENNA 2-13 (VHF-FM)	CCEM-396-1	1			CCEM-396-1		3	2	15	
24	ANTENNA 2-15 (VHF-FM)	CCEM-396-1	1			CCEM-396-1		3	2	15	
25	ANTENNA 3-1 (HF, MINILOOP)	MLA-324	1			CG7610-01-GE8-4101		150	2	17	
26	ANTENNA 3-2 (HF, MINILOOP)	MLA-115	1			CG7610-01-GE8-9610		230	2	17	
27	ANTENNA 3-3, FAN (HF BROADBAND)		1			SHOP FAB			19	13	
28	ANTENNA 3-4, WIRE (MF XMTG)		1			SHOP FAB			19	19	
29	ANTENNA 3-5, FAN (HF BROADBAND)		1			SHOP FAB			19	13	
30	ANTENNA 3-6, WIRE (MF XMTG)		1			SHOP FAB			19	19	
31	ANTENNA 4-3 (UHF DF)	CDYM-TD-L1650	1			OPN MNL A1650		13	11	13	
32	~~ANTENNA 4-4 (VHF ADF)~~	~~AN/SRD-22~~	~~1~~			~~CG7610-GE8-5410~~		~~8~~	~~11~~	~~13~~	
33	ANTENNA 5-1 (ESM)	AS-899EORF/SLR	1			RE-C2699894		268	9	13	
34	ANTENNA 5-2 (ESM)	NT-66131		1		NAVSEA 900,656		30	9	13	
35	ANTENNA 5-3 (ESM)	NT-66132		1		0967-896-4010		35	9	13	
36	ANTENNA 5-4 (ESM)	NT-66132		1		0967-896-4010		35	9	13	
37	ANTENNA 5-5 (ESM)	NT-66131		1		NAVSEA 9000,656		30	9	13	
38	~~ANTENNA 6-1 (X BAND, SURF SRCH)~~	~~AS-3134/AB-1247A~~	~~1~~			~~807-5034947~~		~~148~~	~~4~~	~~15~~	~~W/ANT PEDESTAL~~
39	ANTENNA 6-2 (AIR SRCH RDR)	AS-2782/SPS-40()	1			RE-D2699234		1725	5	16	
40	~~ANTENNA 6-3 (S BAND, SURF SRCH)~~	~~AS-3135/AB-1248~~	~~1~~			~~807-5034947~~		~~332~~	~~4~~	~~15~~	~~W/ANT PEDESTAL~~
41	ANTENNA 7-1 (IFF)	AS-177B/UPX	1			RE-D2699046		7	6	13	
42	ANTENNA 7-2 (IFF)	AS-177B/UPX	1			RE-D2699046		7	6	13	
43	~~ANTENNA 8-2 (AM/FM-VHF/UHF)~~	~~MK22CA~~	~~1~~			~~NAV ELEX AB306~~		~~12.1~~	~~12~~	~~13~~	
44	ANTENNA 10-1 (IFF)	AS-177B/UPX	1			RE-D2699046		7	6	13	
45	ANTENNA (TACAN)	AS-3240( )/URN	1			807-5034290		107	1	16	
46	ANTENNA, 2-14 WHIP (HF, SHORT RANGE)	CCEM-390-2	1			CCEM-390-2		27	2	13	
47	~~ANTENNA/COUPLER (OMEGA II)~~	~~CDED-OMEGA II~~	~~1~~			~~CDED-OMEGA II~~		~~4~~	~~11~~	~~13~~	
48	ANTENNA (LAMPS DATA LINK)	AS-2743/SKR-4	1			RE-D5034359		3	7	13	
49	~~ANTENNA (SONOBUOY RCVR)~~	~~AS-2889/SRC~~	~~1~~			~~0967-475-4010~~		~~7~~	~~7~~	~~13~~	
50	ANTENNA UD401 (MK 92)	MK53 MOD 0	1			NAVSEA 5469711		1960	10	13	
51	ANTENNA (SATL DIR)	AS-3018A/WSC-1(V)	1			0967-614-0010		294	8	13	
52	ANTENNA (SATL DIR)	AS-3018A/WSC-1(V)	1			0967-614-0010		294	8	13	
53	ANTENNA (IFF)	AS-177B/UPX	1			RE-D2699046		7			(SP & WT)
54	UPPER MAN OVBD & BREAKDOWN LIGHT			1				2.5	20	15	SEE GENERAL NOTE 5
55	LOWER MAN OVBD & BREAKDOWN LIGHT			1				2.5	20	15	SEE GENERAL NOTE 5
56	FWD ANCHOR LIGHT (WHITE)			1				7.4	20	14	SEE GENERAL NOTE 5
57	AFT ANCHOR LIGHT (WHITE)			1				7.4	20	14	SEE GENERAL NOTE 5
58	MASTHEAD LIGHT (WHITE)			1				18	20	15	SEE GENERAL NOTE 5
59	RANGE LIGHT (WHITE)			1				18	20	16	SEE GENERAL NOTE 5
60	UPPER TOWING LIGHT (WHITE)			1				18	20	15	SEE GENERAL NOTE 5
61	LOWER TOWING LIGHT (WHITE)			1				18	20	15	SEE GENERAL NOTE 5
62	PORT SIDE LIGHT (RED)			1				18	20	18	SEE GENERAL NOTE 5
63	STBD SIDE LIGHT (GREEN)			1				18	20	18	SEE GENERAL NOTE 5
64	STEERING LIGHT (WHITE)			1				1.1	20	14	SEE GENERAL NOTE 5

DWG NO 378-FRAM-W-401-015 REV M SH 2

EQUIPMENT IDENTIFICATION LIST

SIZE	CAGE CODE	DWG NO.	REV
H	81340	378-FRAM-W-401-015	M
SCALE: NONE	10.42 SQ FT	SHEET 2	

DWG NO 378-FRAM-W-401-010 REV M SH 1

SCALE FACTOR 1 — ELECTRONIC FILENAME 378-FRAM-W_401_15_2_~_M.dwg

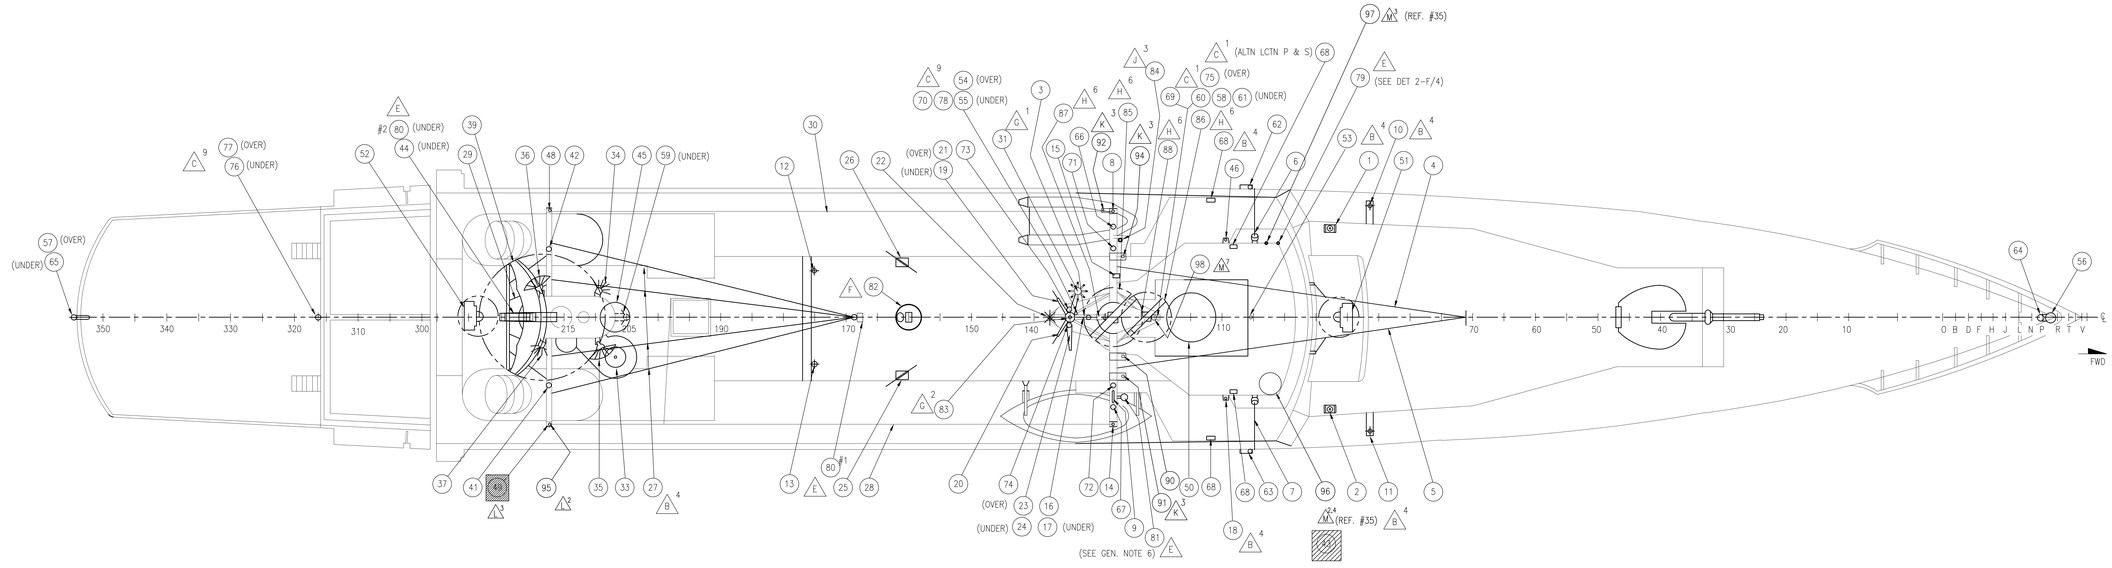

PLAN VIEW

ANTENNA ARRANGEMENT
PLAN VIEW

SIZE	CAGE CODE	DWG. NO.	REV.
H	81340	378-FRAM-W-401-015	M
SCALE: 1/8"-1'-0"	10.42 SQ FT	SHEET 3	

SCALE FACTOR (H) ELECTRONIC FILENAME 378-FRAM-W_401_15_3_-_M.dwg

DWG NO 378-FRAM-W-401-015 REV M SH 3

DWG NO 378-FRAM-W-401-015 REV M SH 3

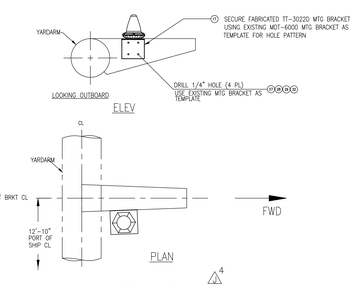

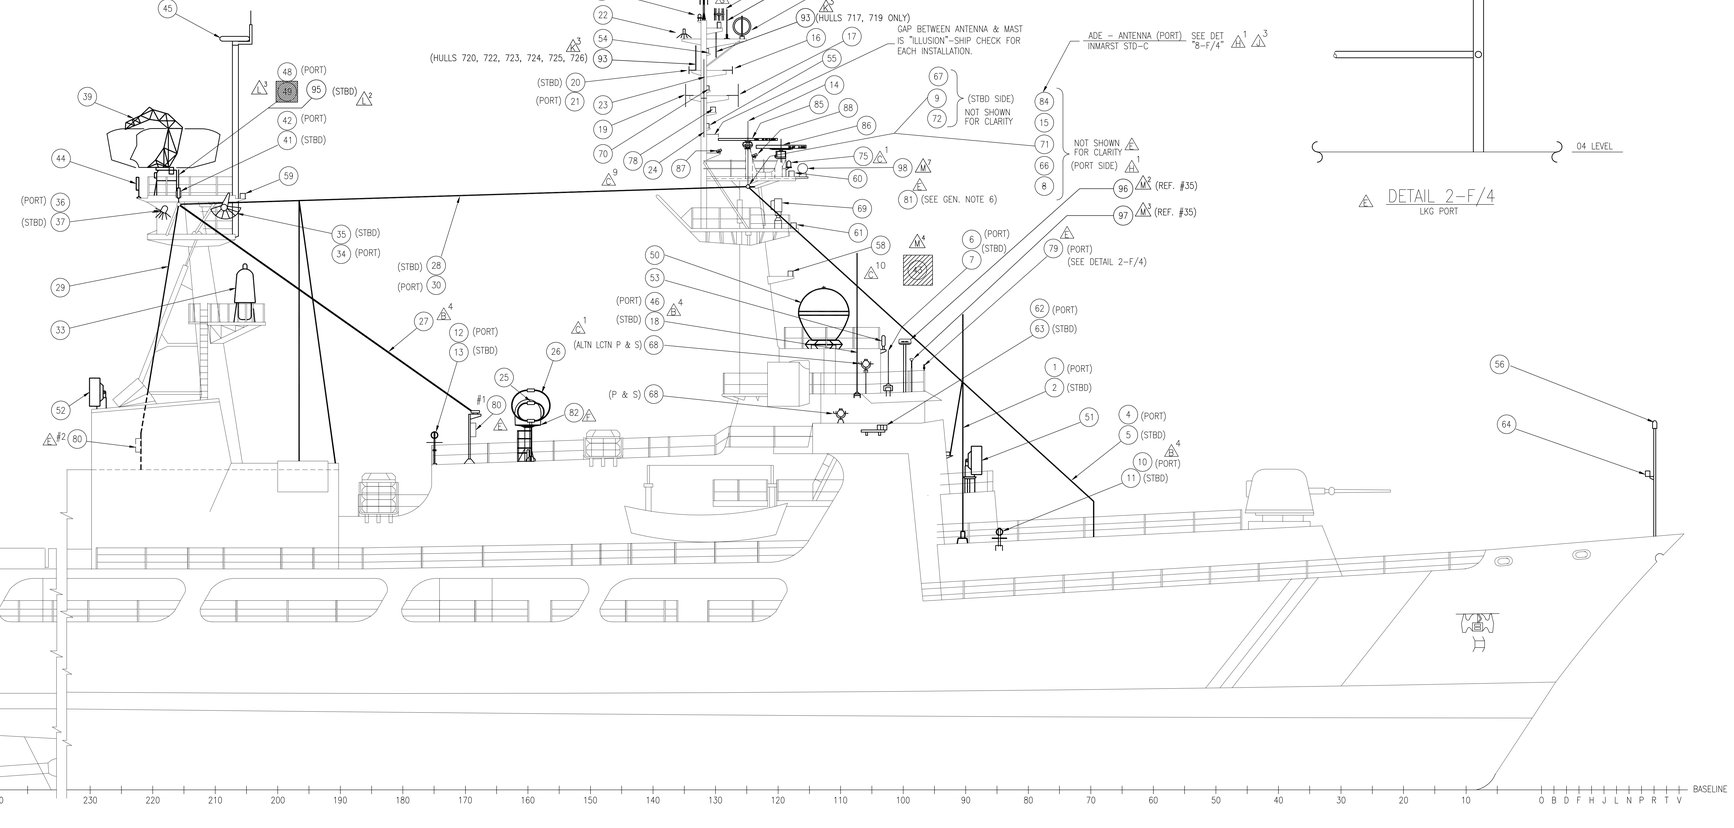

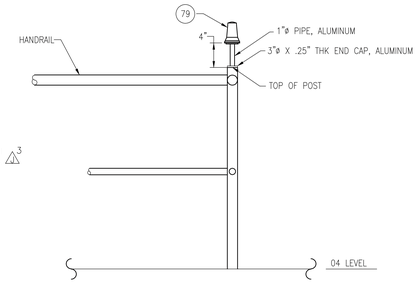

DETAIL 2-F/4
LKG PORT

ELEVATION 5-B/4
LOOKING PORT

ANTENNA ARRANGEMENT
ELEVATION 5-A/4, LOOKING PORT

SIZE	CAGE CODE	DWG. NO.	REV.
H	81340	378-FRAM-W-401-015	M
SCALE: 1/8"=1'-0"		10.42 SQ FT	SHEET 4

SCALE FACTOR 96

ELECTRONIC FILENAME
378-FRAM-W_401_15_4_-_M.dwg

DWG NO 378-FRAM-W-401-015 REV M SH 4